



# Sage Memorial Hospital

NAVAJO HEALTH FOUNDATION

## Ganado Group Home TI

Ganado, AZ

**ADDENDUM NO: 1**  
July 13, 2026


### **ALL CONTRACT BIDDERS OF RECORD, OWNER & CONSULTING ENGINEERS.**

The following changes, additions or deletions are for the above referenced contract documents; all other conditions shall remain the same. Acknowledge receipt of this addendum by inserting its number in the "Bid Form." This addendum forms a part of the contract documents and modifies them as follows:

#### **General Items:**

1. New Bid Date: Wednesday, July 22, 2026, 5:00pm.
2. Items to be included in Bid:
  - a. Replace existing 4ft fencing with New 6 ft Chain Link Fence
  - b. Warranty for this project is 2 (two) Years.
  - c. Insurance, Performance and Payment Bond are required.
  - d. See attached markup of existing drawing C1.1: for areas of concrete sidewalk that have to be removed and replace. (Entry way will have to be addressed for ADA Compliance)
3. The following work will be furnished and performed by the Owner.
  - a. Information Technology (IT)
  - b. Low Voltage Cabling
  - c. Furniture
4. Special Inspection and Testing by Owner

END OF ADDENDUM NO. 1

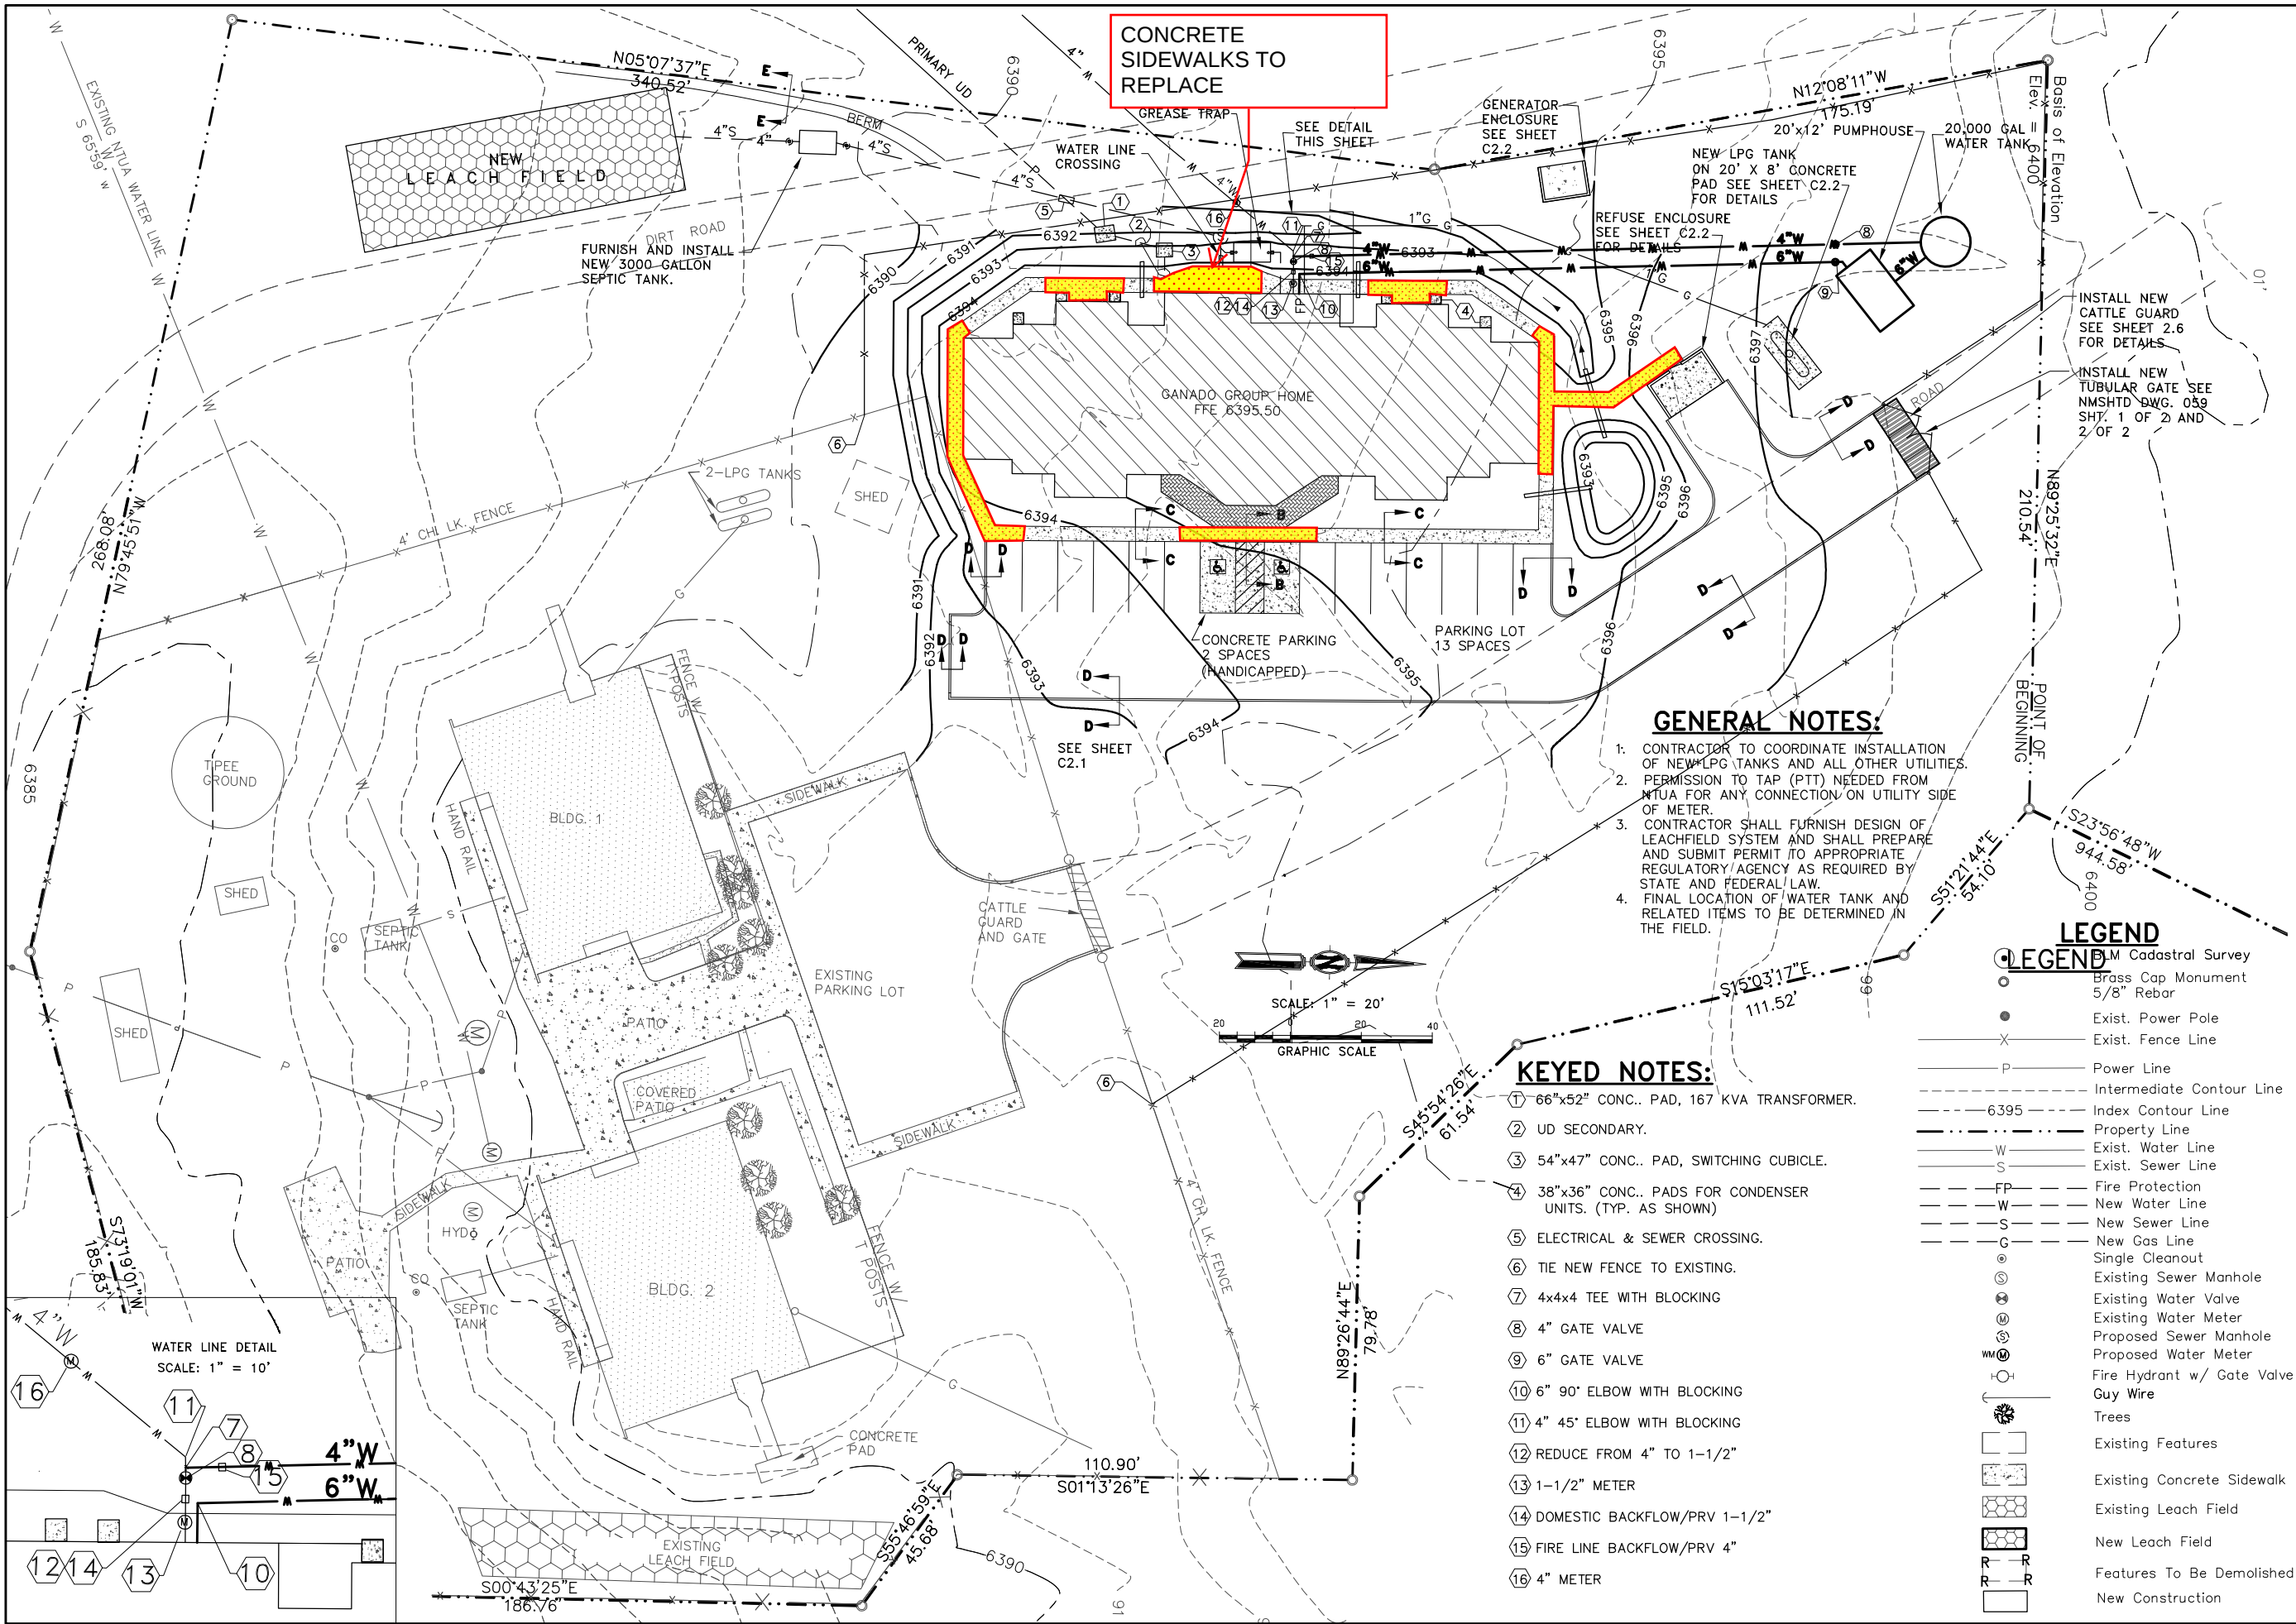

PAIKI  
A NATIVE AMERICAN  
A/E FIRM

Architecture Engineering Planning  
Environmental Science-Land Acquisition  
11000 Lomas Blvd. NE, Suite 100  
Albuquerque, NM 87112  
Ph: (505) 332-1125 Fax: (505) 332-1126

ENGINEER OF RECORD



CLIENT NAME:  
NAVAJO HOUSING AUTHORITY  
FT. DEFANCE, ARIZONA

PROJECT NUMBER:  
NAVAJO HOUSING AUTHORITY  
GANADO & CORNFIELDS GROUP HOME

DESIGNED BY:  
DRAWN BY:  
APPROVED BY:

1 7-21-10 ADD FIRE PROTECTION

2 9-10-10 ADD NTUA REQUIREMENTS

PROJECT NO.  
DATE: 09/10/2010

C1.1

SHT: OF